


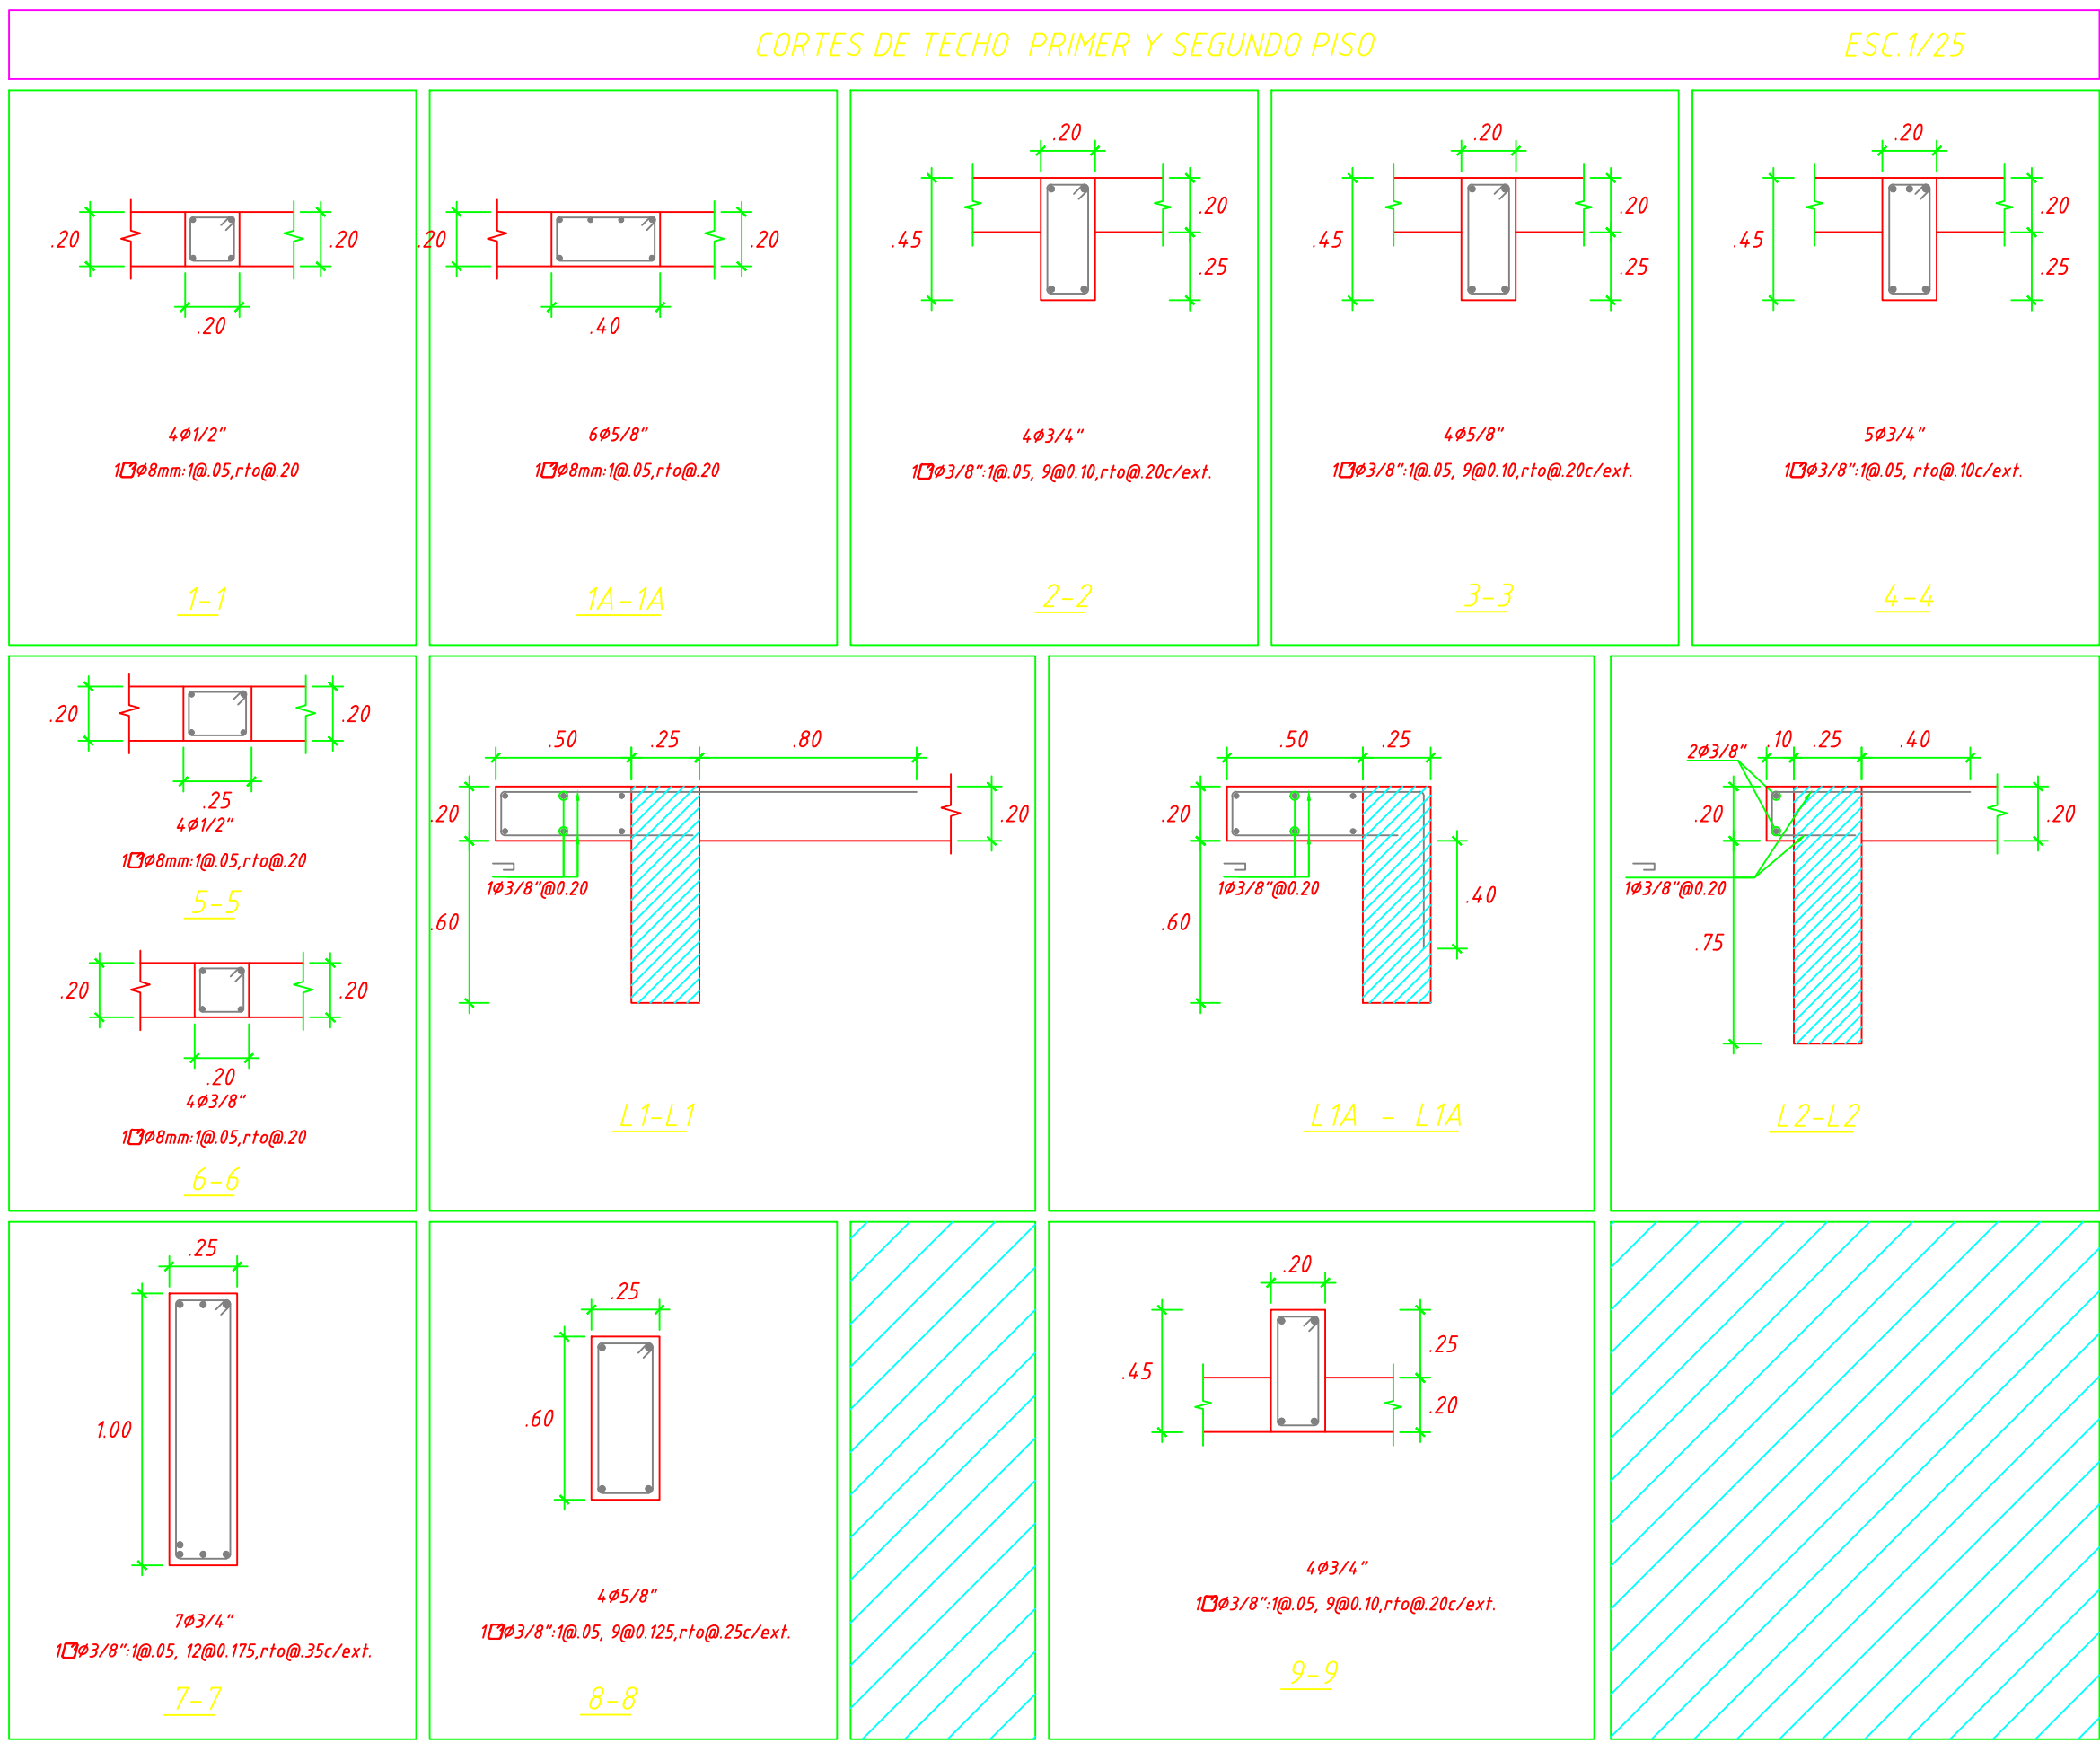

E-06	
FECHA : OCTUBRE 2013	ESCALA : 1/75 1/25