


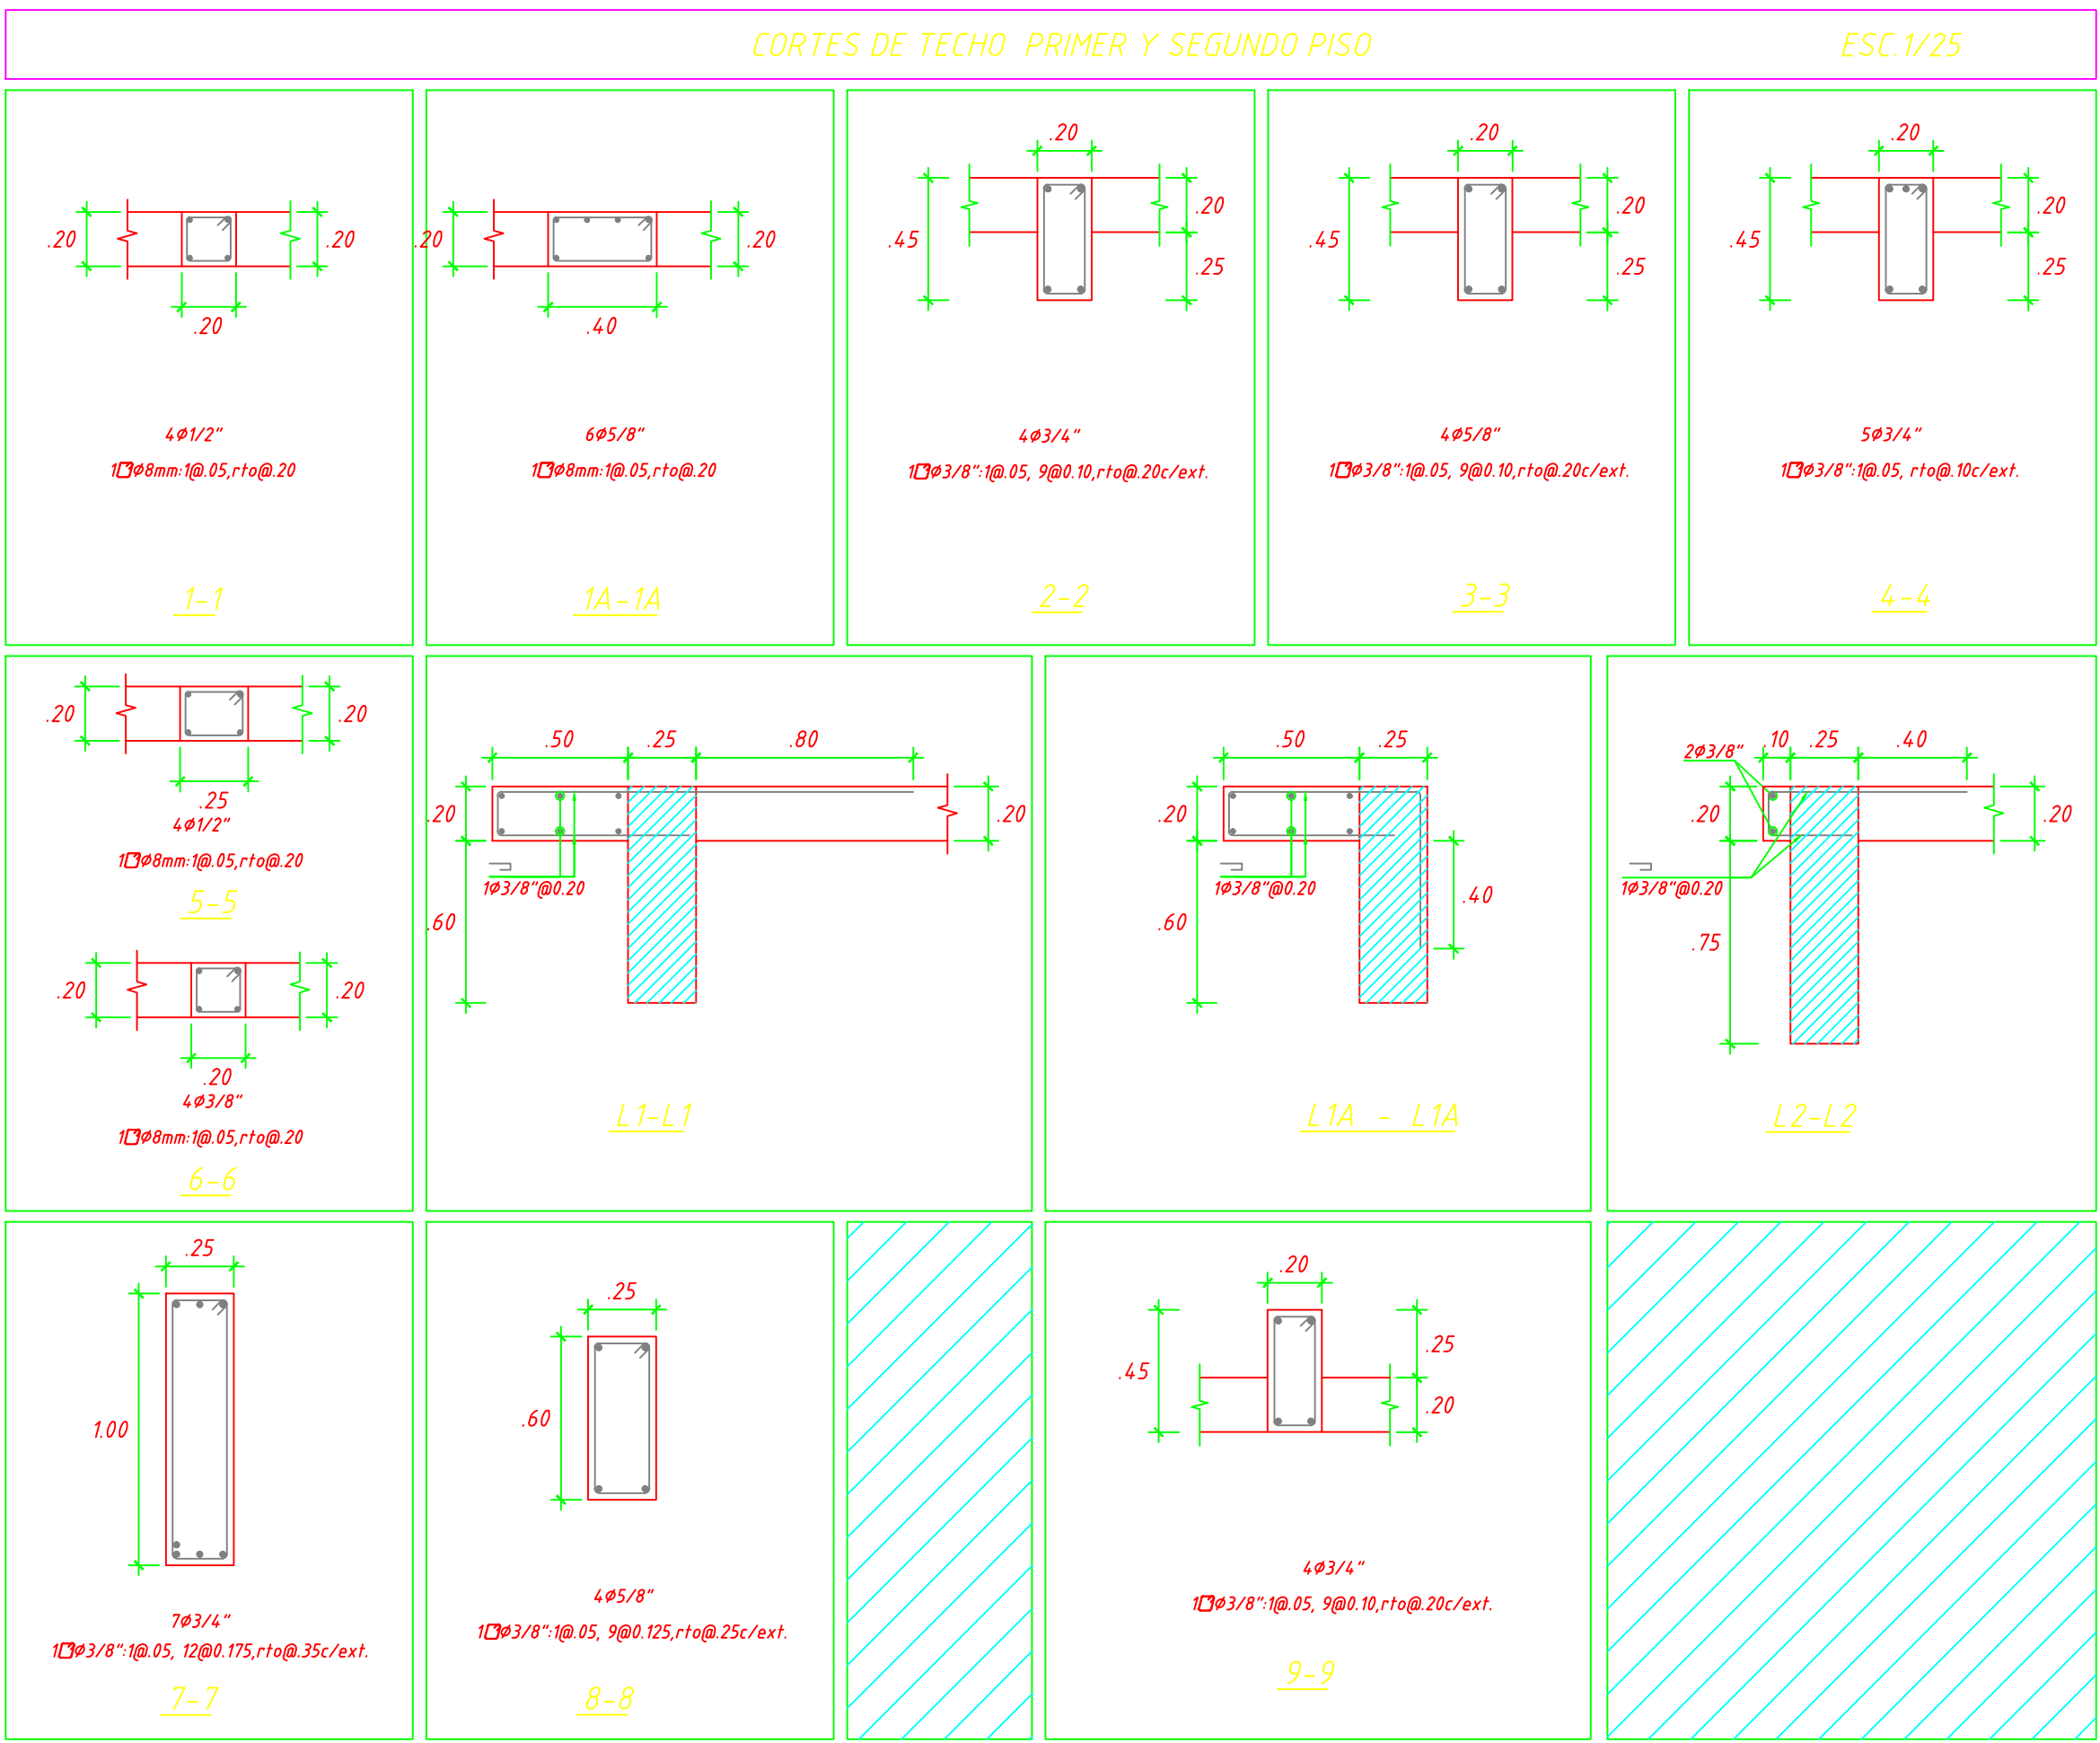

E-07	
FECHA:	ESCALA:
OCTUBRE 2015	1/75 1/25